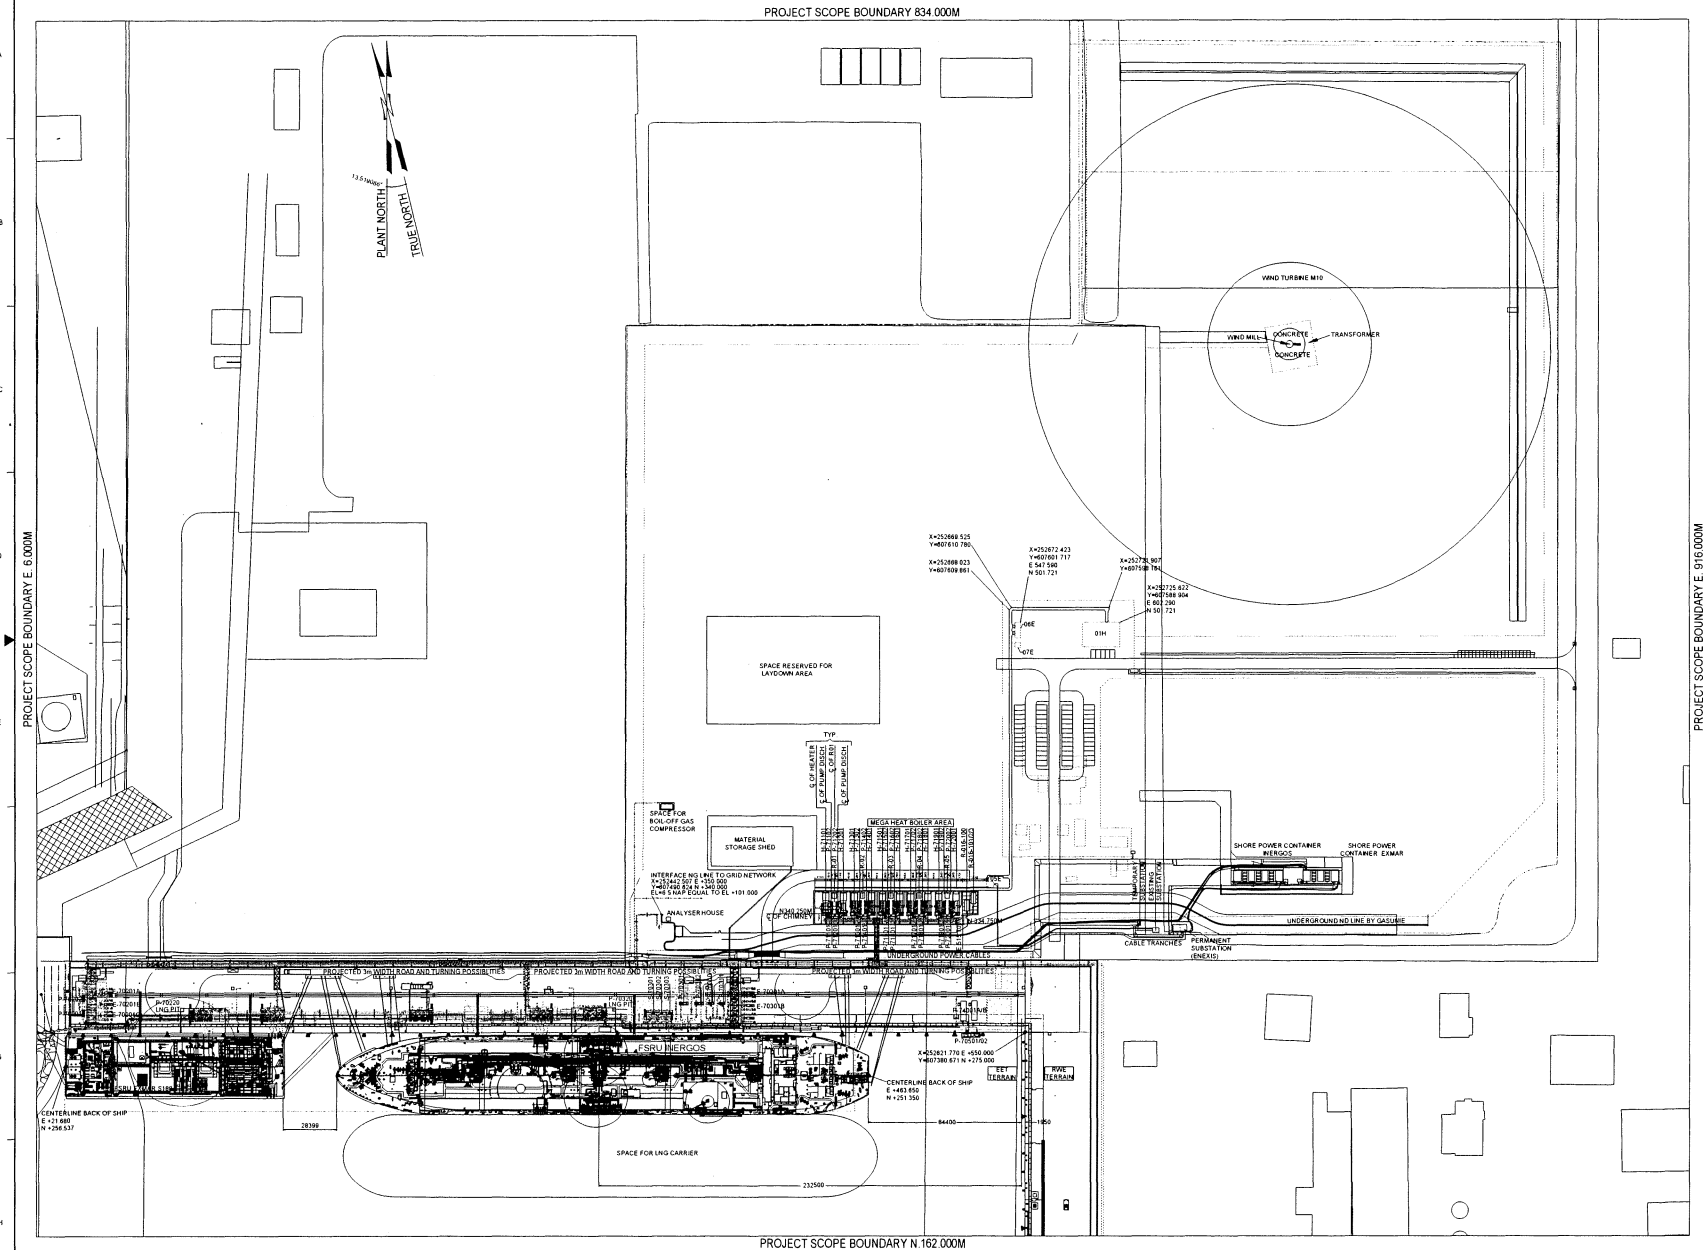

NOTES

1. PROJECT REFERENCE POINT N +0.00 AND E +0.00 EQUAL TO RIJKSDRIEHOEK COORDINATE SYSTEM POINT X=252022.723 Y=607241.964
2. PROJECT REFERENCE COORDINATE EL +100.000 IS EQUAL TO +5.500 N.A.P.
3. ALL DIMENSIONS ARE IN mm UNLESS INDICATED OTHERWISE

EQUIPMENT LIST - EET PROJECT

PUMPS:

P-70201/02	GLYCOL WATER PUMP
P-70220	IMPOUNDING BASIN PUMP
P-70301/02	SEA WATER PUMP
P-70320	IMPOUNDING BASIN PUMP
P-70310	WATER RE-CYCLE PUMP
P-70311S	WATER RE-CYCLE PUMP (SPARE)
P-70501/02	FIRE WATER PUMP
P-740001A/B	MAIN FIRE WATER PUMP

EXCHANGERS:

E-70201A/B/C	GLYCOL / WATER HEATER LOOP
P-70301A/B/C	SEA WATER HEATER LOOP

FILTERS:

S-70301/02/03	SEA WATER FILTER

SHIPS, SHELTER & MISC.

FSRU INERGOS
FSRU EXMAR S188
LNG PIT 2-OPP

01L	SHIP-STATION INERGOS
02L	SHIP-STATION EXMAR
03L	VSU SHELTER INERGOS
04L	VSU SHELTER EXMAR
01R	INSTRUMENT SHELTER

EQUIPMENT LIST - MEGA PROJECT

WATER HEATERS

SHORT TAG	FULL TAG	DESCRIPTION
H-71101	A-440-T-711-H-71101	RL-USED STANDARD HASSL HEATER 1 FROM ZUIDWENING
H-71201	A-440-T-712-H-71201	RL-USED STANDARD HASSL HEATER 2 FROM ZUIDWENING
H-71301	A-440-T-713-H-71301	ECO BOILER M/C NO. 2192
H-71401	A-440-T-714-H-71401	ECO BOILER M/C NO. 2195
H-71501	A-440-T-715-H-71501	ECO BOILER M/C NO. 0217
H-71601	A-440-T-716-H-71601	ECO BOILER M/C NO. 2201
H-71701	A-440-T-717-H-71701	ECO BOILER M/C NO. 2200
H-71801	A-440-T-718-H-71801	ECO BOILER M/C NO. 2205
H-71901	A-440-T-719-H-71901	ECO BOILER M/C NO. 2191
H-72001	A-440-T-720-H-72001	ECO BOILER M/C NO. 2197

MAIN TRANSFER PUMP SKIDS

P-71101	A-440-710-P-71101	ECO PUMP SKID TP100-240 (BYPASS(L)
P-71201	A-440-710-P-71201	ECO PUMP SKID TP100-240 (BYPASS(R)
P-71301	A-440-710-P-71301	ECO PUMP SKID TP100-240 (BYPASS(L)
P-71401	A-440-710-P-71401	ECO PUMP SKID TP100-240 (BYPASS(R)
P-71501	A-440-710-P-71501	ECO PUMP SKID TP100-240 (BYPASS(L)
P-71601	A-440-710-P-71601	ECO PUMP SKID TP100-240 (BYPASS(R)
P-71701	A-440-710-P-71701	ECO PUMP SKID TP100-240 BYPASS(L)
P-71801	A-440-710-P-71801	ECO PUMP SKID TP100-240 BYPASS(R)
P-71901	A-440-710-P-71901	ECO PUMP SKID TP100-240 (BYPASS(L)
P-72001	A-440-710-P-72001	ECO PUMP SKID TP100-240 (BYPASS(R)

RECYCLE PUMP SKIDS

P-71102	A-440-710-P-71102	ECO PUMP SKID TP100-480 CIRC (R)
P-71202	A-440-710-P-71202	ECO PUMP SKID TP100-480 CIRC (L)
P-71302	A-440-710-P-71302	ECO PUMP SKID TP100-480 CIRC (R)
P-71402	A-440-710-P-71402	ECO PUMP SKID TP100-480 CIRC (L)
P-71502	A-440-710-P-71502	ECO PUMP SKID TP100-480 CIRC (R)
P-71602	A-440-710-P-71602	ECO PUMP SKID TP100-480 CIRC (L)
P-71702	A-440-710-P-71702	ECO PUMP SKID TP100-480 CIRC (R)
P-71802	A-440-710-P-71802	ECO PUMP SKID TP100-480 CIRC (L)
P-71902	A-440-710-P-71902	ECO PUMP SKID TP100-480 CIRC (R)
P-72002	A-440-710-P-72002	ECO PUMP SKID TP100-480 CIRC (L)

PRESSURE REDUCING STATION

R-01E-100	R-01E-100	FILTER AND HEATING CONTAINER
R-01E-101/02/A	R-01E-101/102/103	R-GAS FLOW MEASUREMENT & PRESSURE REDUCTION

SHELTERS & MISC.

R-01 TO R-05	ECO ELECTRICAL & INSTRUMENTATION CABINETS
01R	MAIN BUILDING
05L	HANDLING/EXE SHELTER
06E	UPS & DISTRIBUTION SHELTER
07E	BATTERY BUILDING

REFERENCE DRAWINGS

ELNG-FLR-ENG-ELEI-LAY-000001	OVERALL ELECTRICAL EQUIPMENT LAYOUT GASUNIE EET
ELNG-FLR-HSE-HSE-PLN-000001	HAZARDOUS AREA CLASSIFICATION PLAN
ELNG-FLR-ENG-CIVI-PLN-000006	OVERALL PLOT PLAN PERMIT APPLICATION
1640EC-R0-CLD00020001-V	RWE OVERALL PLOT PLAN
A-440-T-CT-000-002 (bam)	HEKWERK EN INRICHTING MASTEN EEMS ENERGY TERMINAL
CEP 35147-TEK-CN-YO-108 (bam)	KABELGOOT OVERGICHT KABELKOKER EN LEGPLAN DEKSELS

HOLDS

1. NONE

REV	DATE	REVISION DESCRIPTION	BY	CHK	APPV	REV	DATE	REVISION DESCRIPTION	BY	CHK	APPV	REFERENCE DRAWINGS	REFERENCE DRAWINGS	REFERENCE DRAWINGS	REFERENCE DRAWINGS
A	22-APR-22	ISSUED FOR COMMENTS	VR	MM	FdH										
1.0	10-MAY-22	APPROVED FOR DESIGN	VR	MM	FdH										
2.0	26-AUG-22	APPROVED FOR CONSTRUCTION	VR	MM	FdH										
3.0	23-OCT-23	APPROVED AS-BUILT	SP	MS	JB										
4.0	11-DEC-24	APPROVED AS-BUILT	RK	RH	JB										

[redacted]

FLUOR.
OPS-CENTER

NOTICE: THIS DRAWING HAS NOT BEEN PUBLISHED AND IS THE SOLE PROPERTY OF FLUOR AND IS LENT TO THE BORROWER FOR THEIR CONFIDENTIAL USE ONLY, AND IN CONSIDERATION OF THE LOAN OF THIS DRAWING, THE BORROWER PROMISES AND AGREES TO RETURN IT UPON REQUEST AND AGREES THAT IT WILL NOT BE REPRODUCED, COPIED, LENT OR OTHERWISE DISPOSED OF DIRECTLY OR INDIRECTLY, NOR USED FOR ANY PURPOSE OTHER THAN THAT FOR WHICH IT IS FURNISHED.

FLUOR DOCUMENT NUMBER
ELNG-FLR-ENG-PIP-PLN-000001

CONTRACT	A&N	
DESIGNED BY	[redacted]	
SUPERVISOR	[redacted]	APP DATE
LEAD DISCIPLINE		APP DATE
FLUOR		APP DATE
CLIENT		APP DATE

A0 BORDER

gasunie
Gasunie Hekwerk Gasunie
Gasunie Eems Energy Terminal

OVERALL PLOT PLAN
GASUNIE EEMS ENERGY TERMINAL

SCALE	DRAWING NUMBER	REV
1 : 1000	A-440-T-LM-000-001	4.0

CAD FILE NAME: ELNG-FLR-ENG-PIP-PLN-000001_4.0.DWG